




- GENERAL NOTES**
- VERTICAL DATUM:
LYTTELTON VERTICAL DATUM 1937
 - ORIGIN OF LEVELS:
EMJY
MA III DP 74453, MA FL. IN
CHANNEL ON LOWES ROAD.
R.L. = 48.616m
SOURCE: LINZ GEODETIC
DATABASE
DATE OF INFORMATION 15.03.17
 - COORDINATES ARE IN TERMS NZGD 2000
MT PLEASANT CIRCUIT.
 - ALL WASTEWATER LATERALS ARE DN100
SN16 UPVC PIPE.
 - ALL WASTEWATER MAINS ARE
DN150 SN16 uPVC.
 - PIPE MATERIALS:
DN100 SN16 uPVC TO AS/NZS 1260:1999
DN150 SN16 uPVC TO AS/NZS 1260:1999
 - ALL PIPEWORK AND FITTINGS WERE
INSTALLED BETWEEN NOVEMBER 2018 AND
SEPTEMBER 2019.

- LEGEND AS BUILT**
- FLOW DIRECTION
 - WASTEWATER LINE
 - WASTEWATER LATERAL
 - WASTEWATER MANHOLE
- LEGEND EXISTING**
- WASTEWATER LINE
 - WASTEWATER MANHOLE

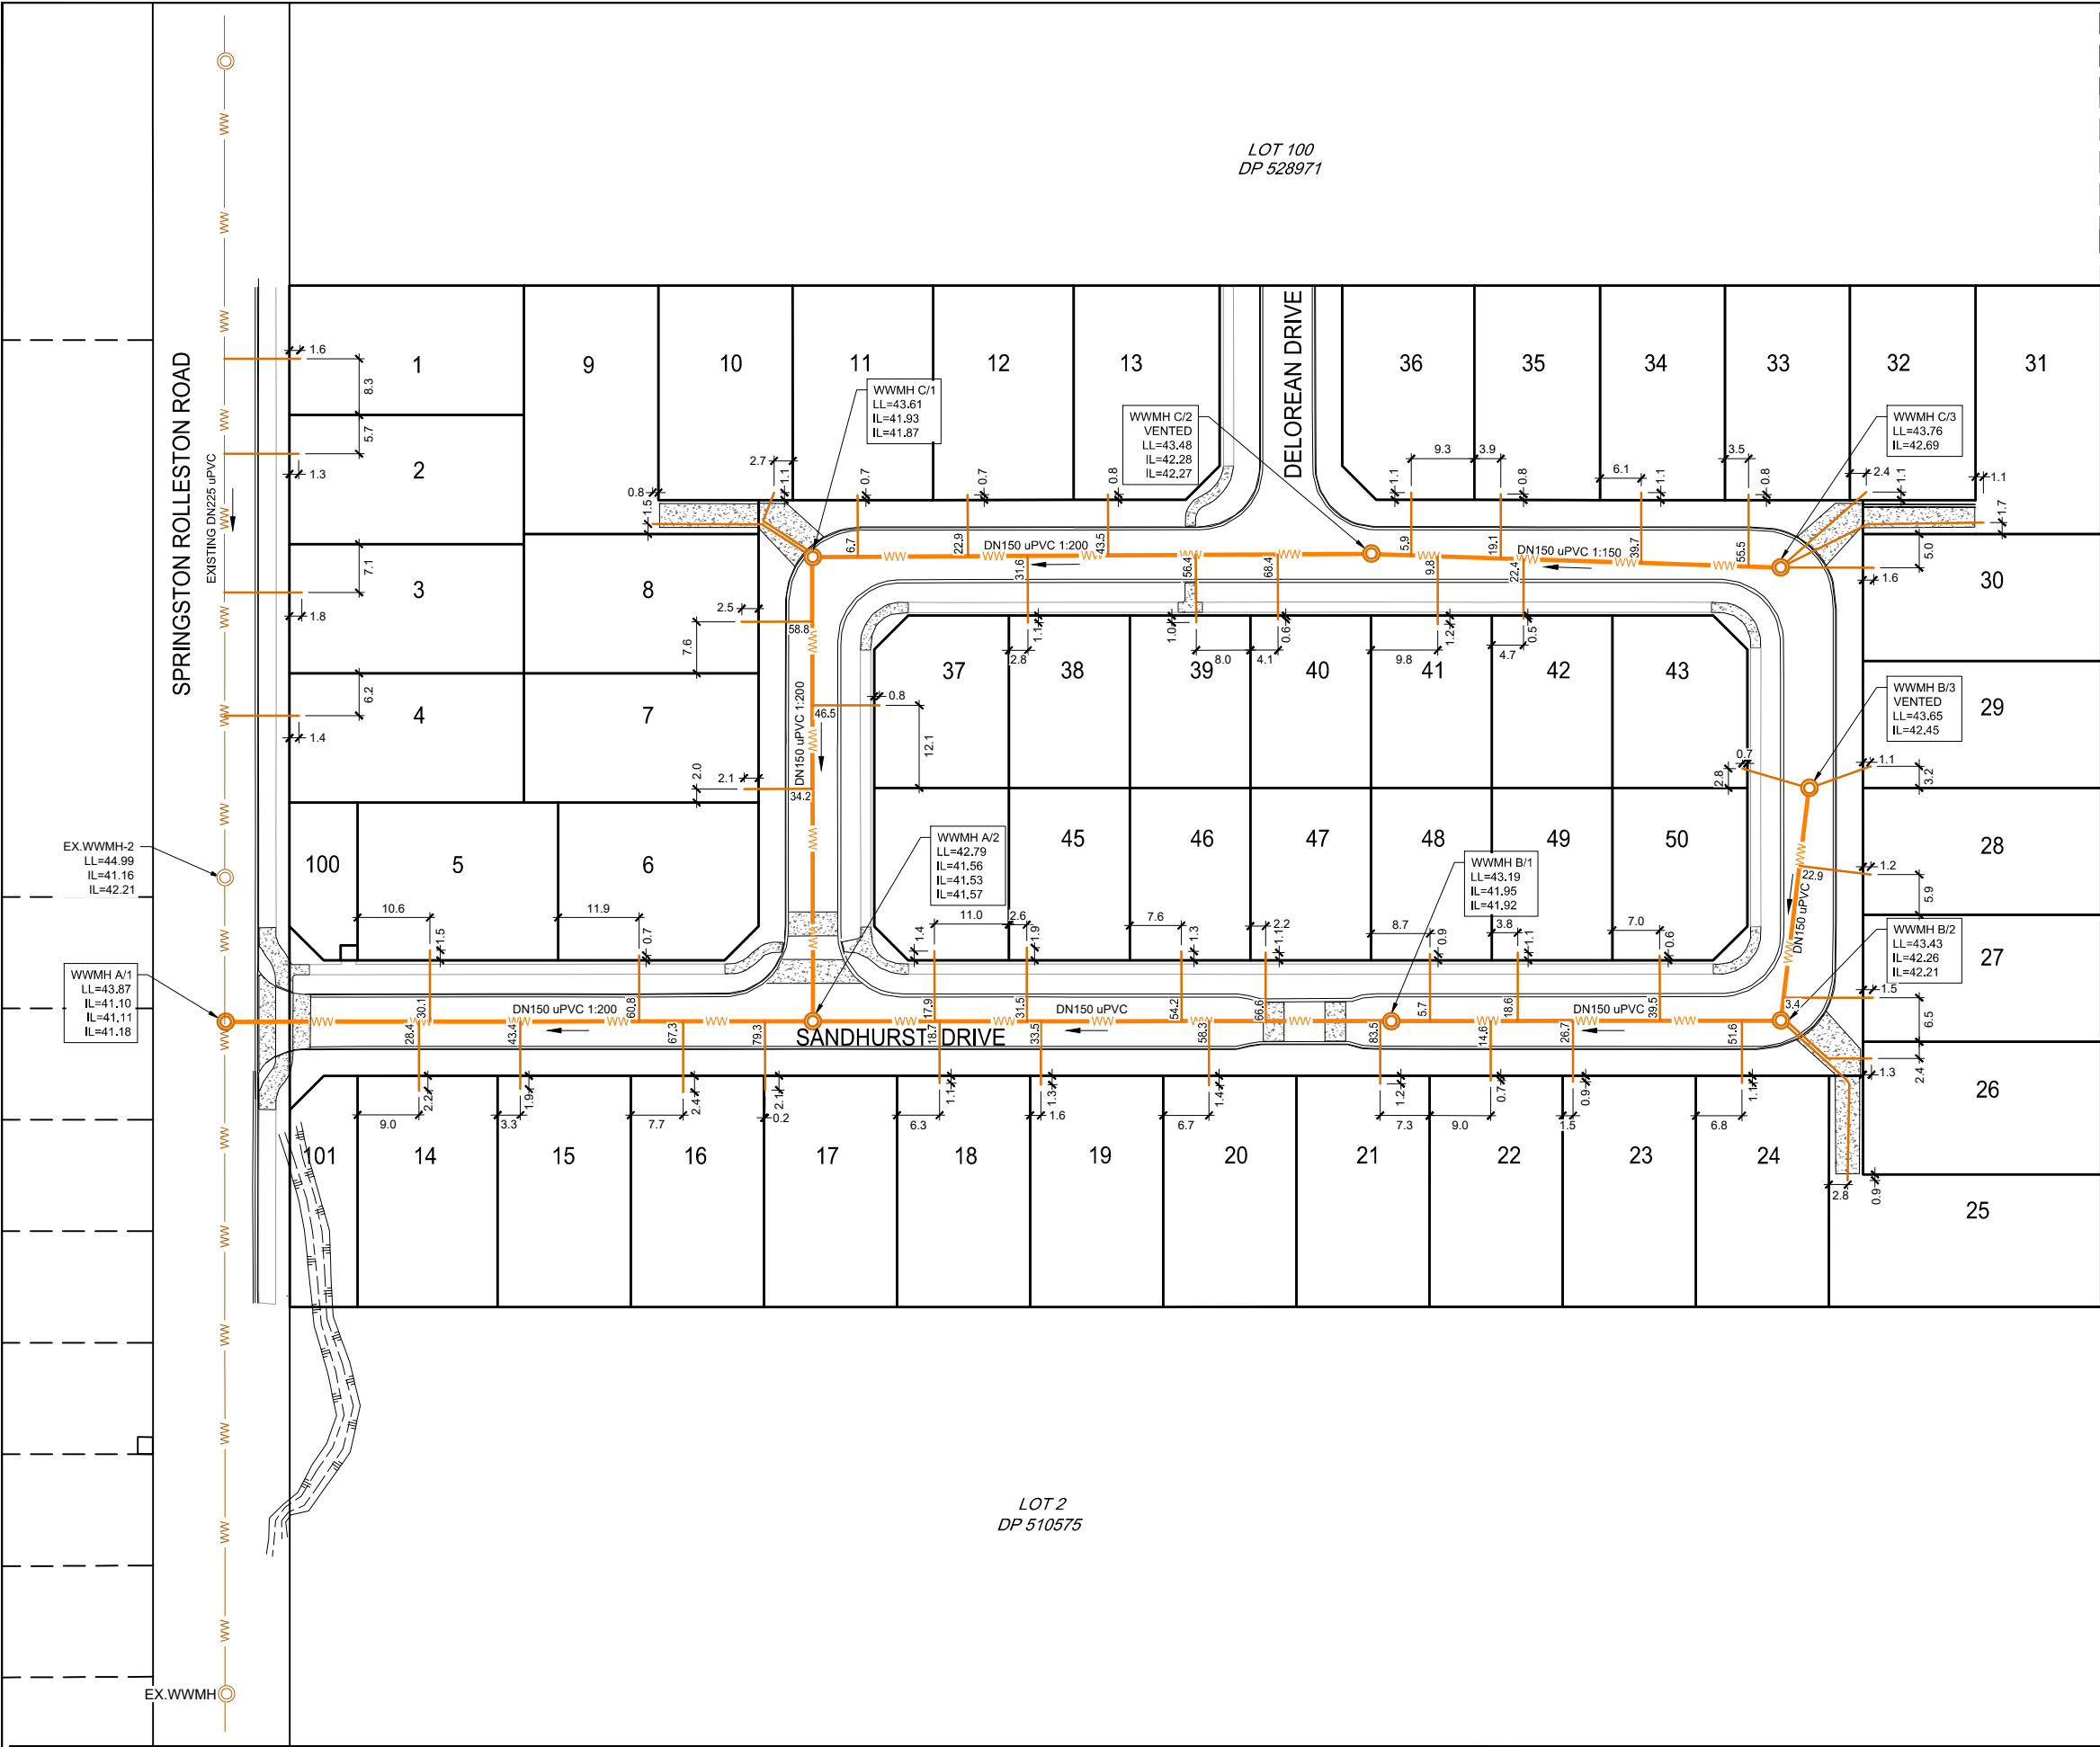

Lot 14
DP 535457

Lot 13
DP 535457

LOT 13
DP 66535

LOT 2
DP 510575

AS BUILT ONLY



0 ISSUED FOR S224

Revision	App	Date	Approved
0	WB	27.09.19	W. BLANCHFIELD

Surveyed	Designed	Drawn	Reviewed	App	Date	Approved
SW & JS	BH	JK	WB	WB	27.09.19	W. BLANCHFIELD

Client
URBAN ESTATES LIMITED


Project Title
**SANDHURST
582 SPRINGSTON
ROLLESTON ROAD
SUBDIVISION**

Sheet Title
**WASTEWATER
AS BUILT PLAN**

Level 1
323 Madras Street
Christchurch 8042
+64 3 374 6515
calibreconsulting.co



Scale (A1 Original) 1:500 (A3) 1:1000

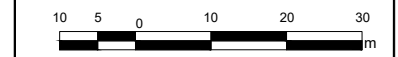

Project No Sheet Revision

710811.002 C710 0