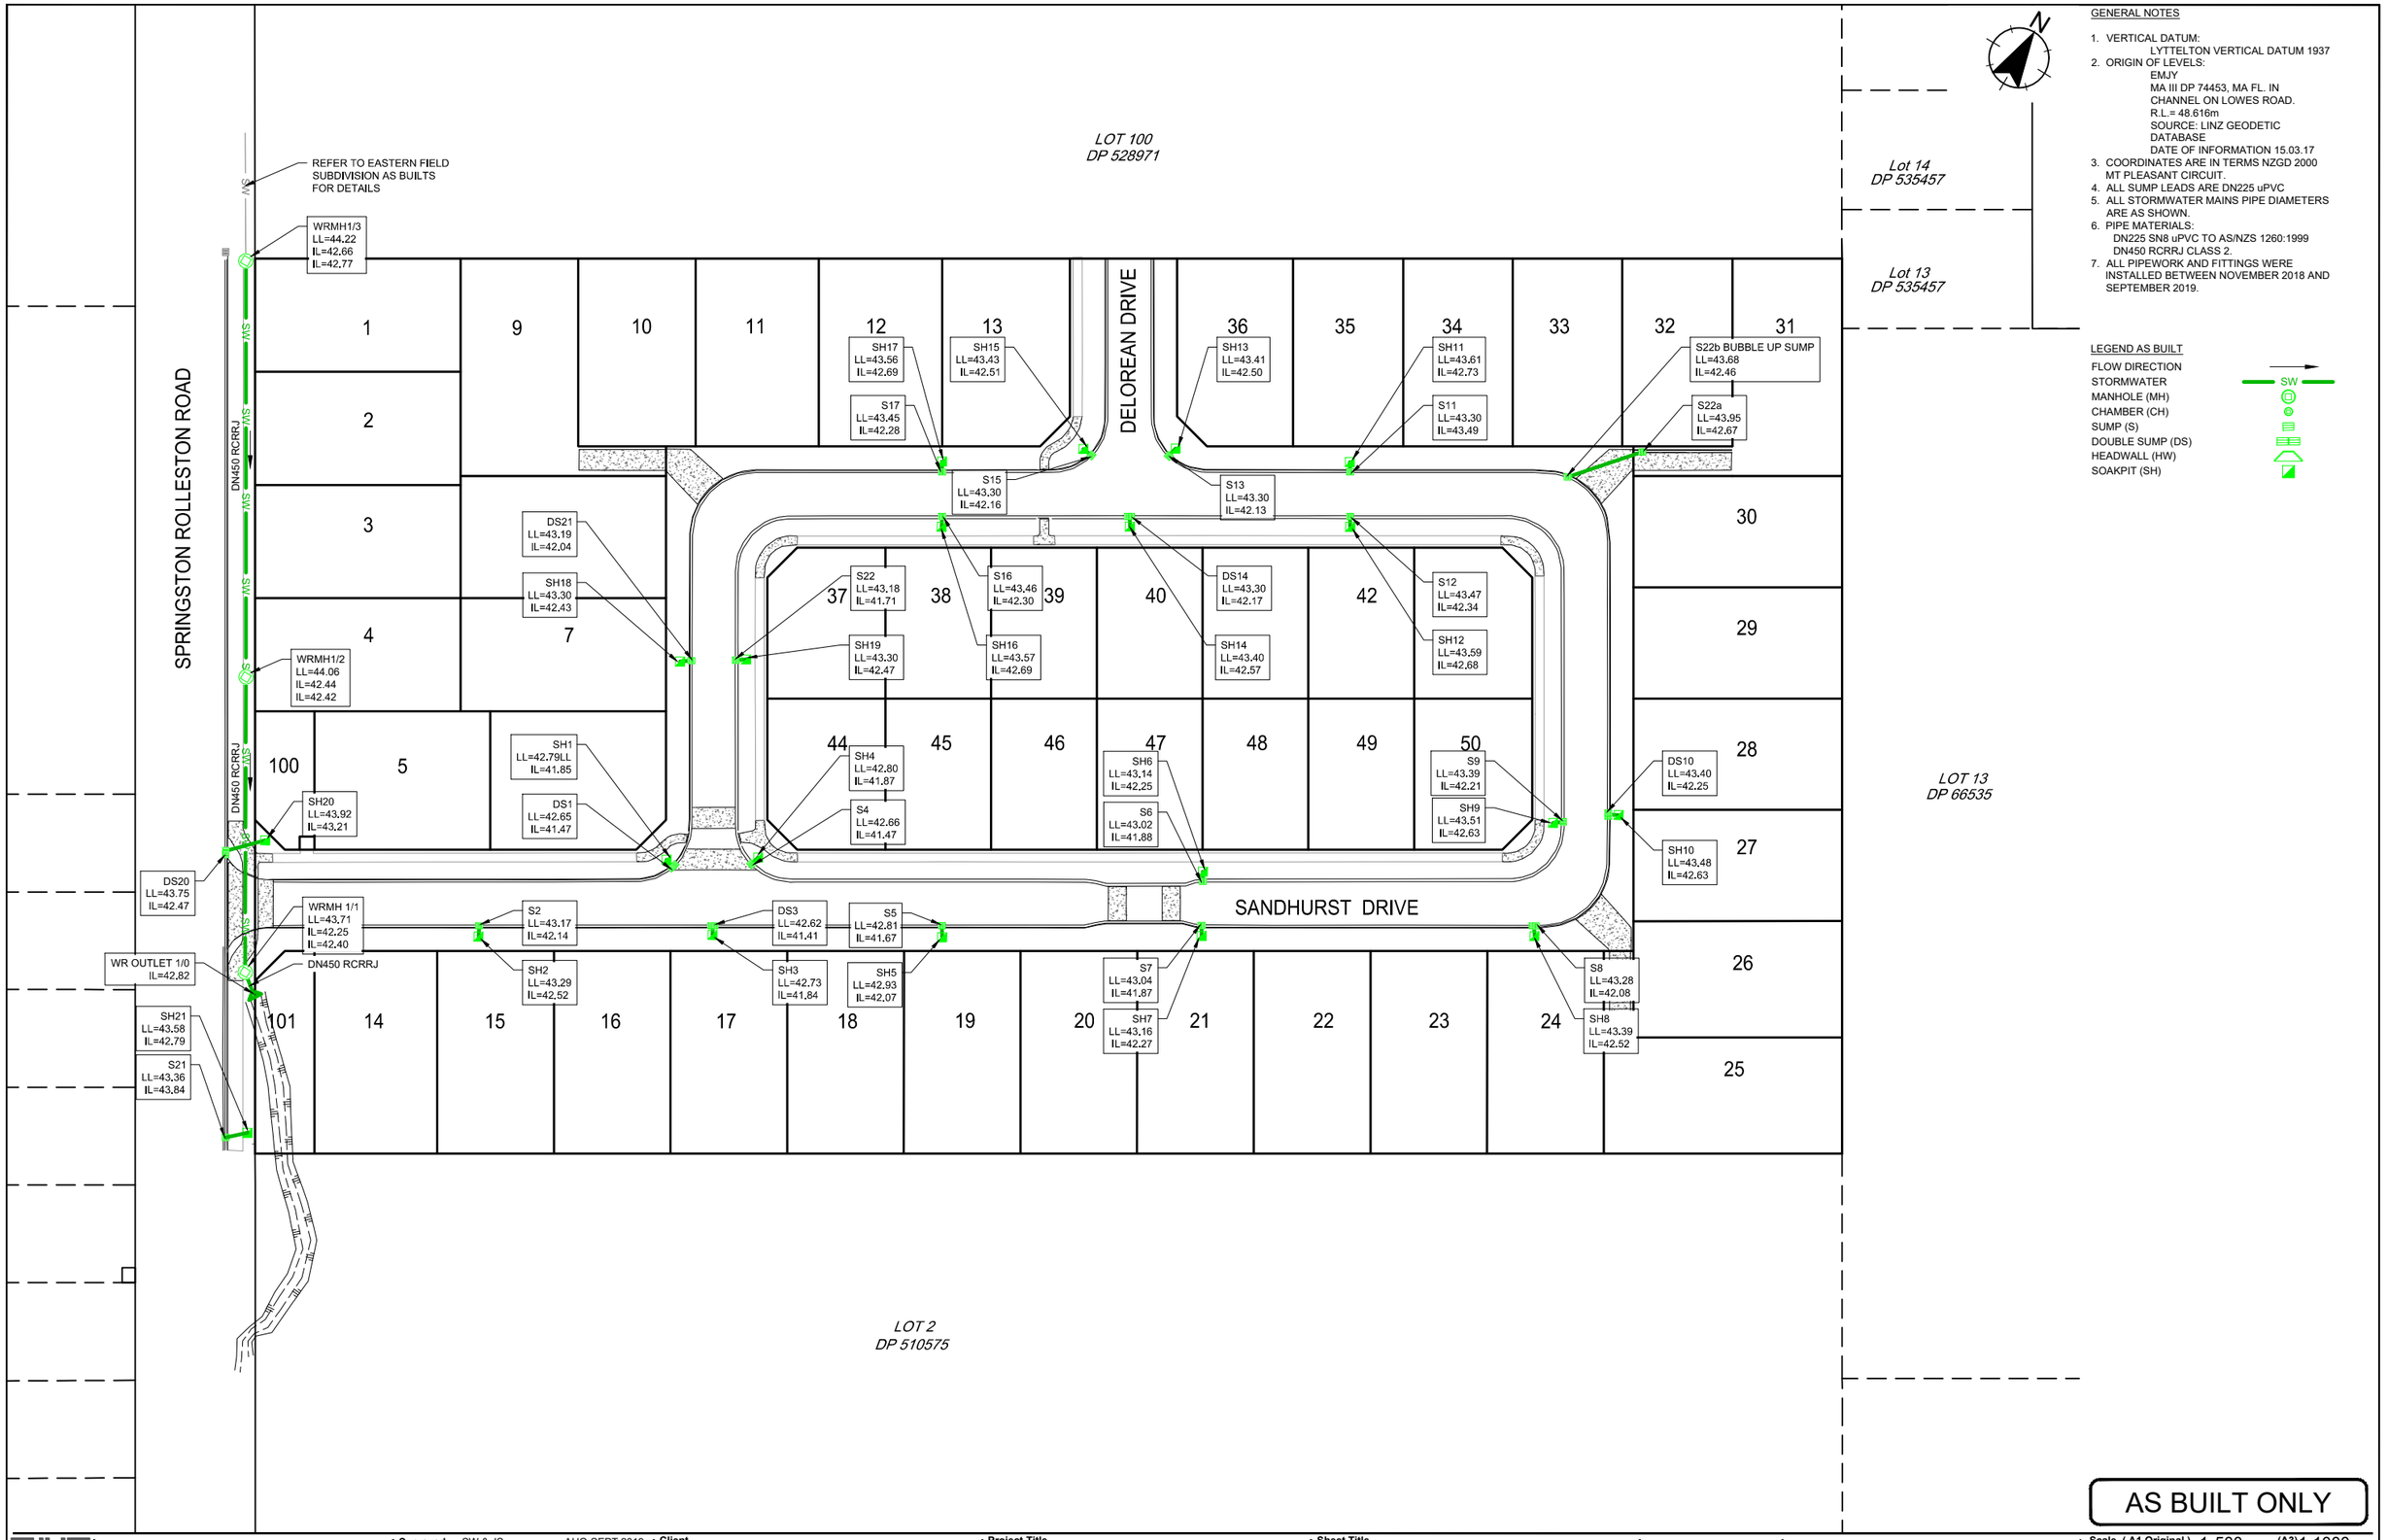

GENERAL NOTES

1. VERTICAL DATUM:
   LYTTELTON VERTICAL DATUM 1937
2. ORIGIN OF LEVELS:
   EMJY
   MA III DP 74453, MA FL. IN
   CHANNEL ON LOWES ROAD.
   R.L.= 48.616m
   SOURCE: LINZ GEODETIC
   DATABASE
   DATE OF INFORMATION 15.03.17
3. COORDINATES ARE IN TERMS NZGD 2000
   MT PLEASANT CIRCUIT.
4. ALL SUMP LEADS ARE DN225 uPVC
5. ALL STORMWATER MAINS PIPE DIAMETERS ARE AS SHOWN.
6. PIPE MATERIALS:
   DN225 SN8 uPVC TO AS/NZS 1260:1999
   DN450 RCRRJ CLASS 2.
7. ALL PIPEWORK AND FITTINGS WERE INSTALLED BETWEEN NOVEMBER 2018 AND SEPTEMBER 2019.

LEGEND AS BUILT

FLOW DIRECTION
STORMWATER — SW
MANHOLE (MH)
CHAMBER (CH)
SUMP (S)
DOUBLE SUMP (DS)
HEADWALL (HW)
SOAKPIT (SH)

AS BUILT ONLY

Revision	App	Date
0 ISSUED FOR S224	WB	27.09.19

Surveyed	SW & JS	AUG-SEPT 2019
Designed	BH	27.09.19
Drawn	JK	27.09.19
Reviewed	BH	27.09.19
Approved	W. BLANCHFIELD	27.09.19

Verify all dimensions on site before commencing work. Prioritise figured dimensions over scaling. Refer all discrepancies to Calibre.
This document and the copyright in this document remain the property of Calibre Consulting Limited. The contents of this document may not be reproduced either in whole or in part by any means whatsoever without the prior written consent of Calibre Consulting Limited.

Client
URBAN ESTATES LIMITED

Project Title
SANDHURST
582 SPRINGSTON
ROLLESTON ROAD
SUBDIVISION

Sheet Title
STORMWATER
AS BUILT PLAN

Level 1
323 Madras Street
Christchurch 8042
+64 3 374 6515
calibreconsulting.co

Scale (A1 Original) 1:500 (A3) 1:1000
10 5 0 10 20 30 m

Project No	Sheet	Revision
710811.002	C720	0

H:\CHC\7108xx\710811.002 582 Springston Rolleston Development\320 Drawings\3_Drawing\710811.002-C720.dwg, Plotted By Jonnie Kerr at 27/09/2019 4:04:26 PM Scale 1:2